

Environmental Services - Water Quality
Onsite Wastewater Scan Data Entry Form

PERMIT #: D035107

PIN #: 0771771849

OP DATE: 111512006

SYSTEM USE:

- House
- Mobile Home
- Business
- Other

SEWAGE TYPE:

- Domestic
- Industrial

PUMP/SIPHON?:

- Yes
- No

PRESSURE MANIFOLD:

- Yes
- No

SYSTEM TYPE:

- I
- II
- III
- IV
- V
- VI
- Other

SUB TYPE:

- A
- B
- C
- D
- E
- F
- G

NBR BEDROOMS:

- 1
- 2
- 3
- 4
- 5
- 6
- Other

MAINT. SCHEDULE:

- Yes
- No

CERT. OPERATOR

- Yes
- No

GT ST PT

-
-
SIZE

- 750
- 900
- 1,000
- 1,200
- 1,500
- 1,800
- 2,100
- 2,500
- 3,000
- 4,000
- 5,000
- 8,000
- 10,000
- Other
- None/NA GT or PT

DRAINFIELD SIZE(SQ. FT.)

01200

DRAIN TYPE:

- Stone
- EZ Flow
- Infiltrator
- Biodiffuser
- Cultec
- Drip
- Hancor
- Large Dia. Pipe
- Multi-Pipe
- Other

MAX DEPTH (IN.):

- 12 in. or less
- 18 in. or less
- 24 in. or less
- 26 in. or less
- 28 in. or less
- 30 in. or less
- 32 in. or less
- 36 in. or less
- Other

STONE DEPTH (IN.):

- 8 in. or less
- 12 in. or less
- 18 in. or less
- 24 in. or less
- Other

TRENCHES:

- Individual
- Bed

TRENCH WIDTH (IN.):

- 12 in. or less
- 18 in.
- 24 in.
- 36 in.
- 6 ft. or less
- 9 ft. or less
- Other

Omni

WAKE COUNTY DEPARTMENT OF ENVIRONMENTAL SERVICES WELL AND SEWAGE SITE LOCATION PERMIT
NO PERMIT(S) FOR CONSTRUCTION, LOCATION OR RELOCATION ACTIVITY SHALL BE ISSUED
UNTIL AN AUTHORIZATION FOR WASTEWATER SYSTEM CONSTRUCTION HAS BEEN ISSUED
PERMIT VOID IF NOT IN COMPLIANCE WITH ZONING REGULATIONS AND/ OR IF SITE IS ALTERED OR INTENDED USE CHANGED

PERMIT#: D035107 STATUS: A APP. DATE: 09/30/2005 BLDG. PERMIT#: 0061105
 PIN: 0771.02 76 9539 000 TAX MAP: 0652 0010 RECORDED: Y ORIG. PERMIT#:
 TOWNSHIP: 18 SWIFT CREEK JURISDICTION: WC ZONING: R40
 APPLICANT: TOLL BROTHERS OF NC IN
 2310 T W ALEXANDER DR STE G
 RALEIGH, NC 27617
 (919) 795 - 0691
 USE: HD USE: 101 ONE-FAMILY HOUSE
 EXIST USE:
 DISPOSAL: BEDROOMS: 4 BASEMENT: Y #EMPLOYEES: 0
 SITE: ADDRESS: 4708 HALEY TREE CT
 SUBDIVISION: OAKS AT MEADOWR LOT: 09 ACRES: 0.75
 DIRECTION: HOLLY SPRINGS RD S L FIELDING DRIVE TO SUB

Well System: WATER: COMMUNITY - TYPE: EXISTING

WELL LOG INFORMATION: DEPTH: _____ CASING DEPTH: _____ YIELD: _____ STATIC LEVEL: _____
 WELL CONTRACTOR: _____ REG.# _____ PUMP CONTRACTOR: _____ REG.# _____
 Construction Compliance GROUT APPROVED DATE _____ EHS _____
 WELLHEAD APPROVED DATE _____ EHS _____
 SYSTEM FINALIZED DATE _____ EHS _____

COMMENTS:

Operation Permit

DESIGN FLOW: _____ gal./min. ACTUAL FLOW: _____ INNOVATIVE LETTER: _____
 INSTALLED BY: Glen Todd INSTALLATION APPROVED BY: Cosy Fajh
 PROPRIETARY SYSTEM: _____ FILTER NO: _____
 COMMENTS:
 OPERATIONS PERMIT ISSUED? Y OP DATE: 11-15-06 BY: Travis A. Horvath

This permit is based in part on information provided by the homeowner or his/her representative in the application submitted for this permit. The Environmental Health Specialist is not responsible for false or misleading information contained in the application. The Environmental Health Specialist is also not responsible for concealed conditions on the property or for statements in this report that may have resulted from false or misleading statements provided to him in the application. Neither Wake County nor the Environmental Health Specialist warrants that the septic tank system will continue to function satisfactorily in the future or that the water supply will remain potable.

As Built Information:

Date: 11-2-06 Benchmark: _____ Rod reading: _____ Distance to Structure: _____
 ST: 1200 gals ID#: STB 957 D.O.M.: 6-16-06 Elev.: 4'13 3/4" Distance to Well: _____
 PT: 1200 gals ID#: PT 170 D.O.M.: 6-16-06 Elev.: 5'8"
 D-box/FD/PM elev.: _____ Supply Line: _____ ft. Pump/Control Panel: _____
 Line 1: 5'7 1/2" _____ Date: _____
 Line 2: 6'9" _____ Date: _____
 Line 3: 7'7" _____ Date: _____
 Line 4: 8'1" _____ Date: _____
 Line 5: _____ Date: _____
 Distance to P/L: _____ Notes: _____

Need Pump Final
No D-Box at SD

WAKE COUNTY DEPARTMENT OF ENVIRONMENTAL SERVICES WELL AND SEWAGE SITE LOCATION PERMIT
NO PERMIT(S) FOR CONSTRUCTION, LOCATION OR RELOCATION ACTIVITY SHALL BE ISSUED
UNTIL AN AUTHORIZATION FOR WASTEWATER SYSTEM CONSTRUCTION HAS BEEN ISSUED

PERMIT VOID IF NOT IN COMPLIANCE WITH ZONING REGULATIONS AND/ OR IF SITE IS ALTERED OR INTENDED USE CHANGED

PERMIT#: D035107 STATUS: A APP. DATE: 09/30/2006 BLDG. PERMIT#: 0061105
PIN: 0771.02 76 9539 000 TAX MAP: 0652 0010 RECORDED: Y ORIG. PERMIT#:
TOWNSHIP: 18 SWIFT CREEK JURISDICTION: WC ZONING: R40
APPLICANT: TOLL BROTHERS OF NC IN
2310 T W ALEXANDER DR STE G
RALEIGH, NC 27617
(919) 795 - 0591
USE: HD USE: 101 ONE-FAMILY HOUSE
EXIST USE:
DISPOSAL: BEDROOMS: 4 BASEMENT: Y #EMPLOYEES: 0 FOUND DRAIN:
SITE: ADDRESS: 4708 HALEY TREE CT
SUBDIVISION: OAKS AT MEADOWR LOT: 09 ACRES: 0.75
DIRECTION: HOLLY SPRINGS RD S L FIELDING DRIVE TO SUB

IMPROVEMENT PERMIT

TANK SIZE: 1200 gal. PUMP Tank: 1200 gal. SQ FT: 1200 INNOVATIVE MAX DEPTH LINE: 24 in.
WASTEWATER: INDIVIDUAL SEWAGE: DOMESTIC TYPE SYSTEM: III G PUMP: Y P/M: N
DAILY FLOW: 480 gal/day DESIGN FEE REQ?: PAID?: WATER: COMMUNITY

COMMENTS:

IP ISSUED? Y DATE: 03/17/2006 BY: (AMH) *Adrienne Robinson* PHONE#:

AUTHORIZATION FOR WASTEWATER/WATER SYSTEM CONSTRUCTION

VOID SIXTY (60) MONTHS FROM DATE OF ISSUANCE

AUTHORIZATION CONDITIONS:

Contractors shall install system on contours, see attached site plan for wastewater system design and well location. No underground utilities, water lines or sprinkler systems may be located in the original system or repair areas. A septic tank filter with a riser for access is required. The wastewater system shall not be covered or placed into use until inspected by the Wake County Department of Environmental Services and an Operation Permit issued. An Accepted Status System may be used in place of conventional system, if it can be placed in the permitted/authorized trench footprint (except reduction in line length and/or number as allowed for in approval) and the installation is in accordance with the accepted system approval, without unauthorized product alteration. If permit required use of an Accepted Status System, substitution with another accepted status system may be made, as long as no changes are necessary in the location of each nitrification line (including any increase in line length), trench depth or effluent distribution method. If changes are necessary, prior approval by this office is required before system installation. **OTHER CONDITIONS:**

INSTALL SYSTEM AS SHOWN ON SITE PLAN. DO NOT GRADE OR FILL IN SEPTIC OR REPAIR AREA. CALL PRIOR TO INSTALLATION WITH ANY QUESTIONS.

TANK SIZE: 1200 gal. PUMP TANK: 1200 gal. SQ FT: 1200 INNOVATIVE MAX DEPTH LINE: 24 in.
MAINT: N OPER: N L/O: N TRENCH#: 4 LENGTH: 100 ft. WIDTH: 36 in. DESIGNER: ___
SUBFIELDS: ___ DESIGN HEAD PRESSURE: ___ DESIGN FLOW: ___ gal/min DOSE VOLUME: ___ gal.

CA ISSUED? Y DATE: 03/17/2006 BY: (AMH) *Adrienne Robinson* PHONE#: 422-3751


I, MICHAEL P. GRIFFIN, certify that under my direction and supervision this map was drawn from an actual field survey; that the error of closure of the survey as calculated by coordinates is 1:10,000+; that the area shown herein was calculated by coordinates.
 Witness my hand and seal this DAY day of MONTH 2005.

AS BUILT
 0061105
 D35107

N
 BM 2005 PAGE 1888-1891
 WAKE CO. REGISTRY

Zoning R40 By Self
 Approve Date 10/15/06
 Revise _____ Use Lot
 Reject _____ MBL _____
 Front 15 Rear 30 Perimeter
 Side 7.5 Corner _____
 Comments: Revised

N/F
 JAMES A. HARWARD

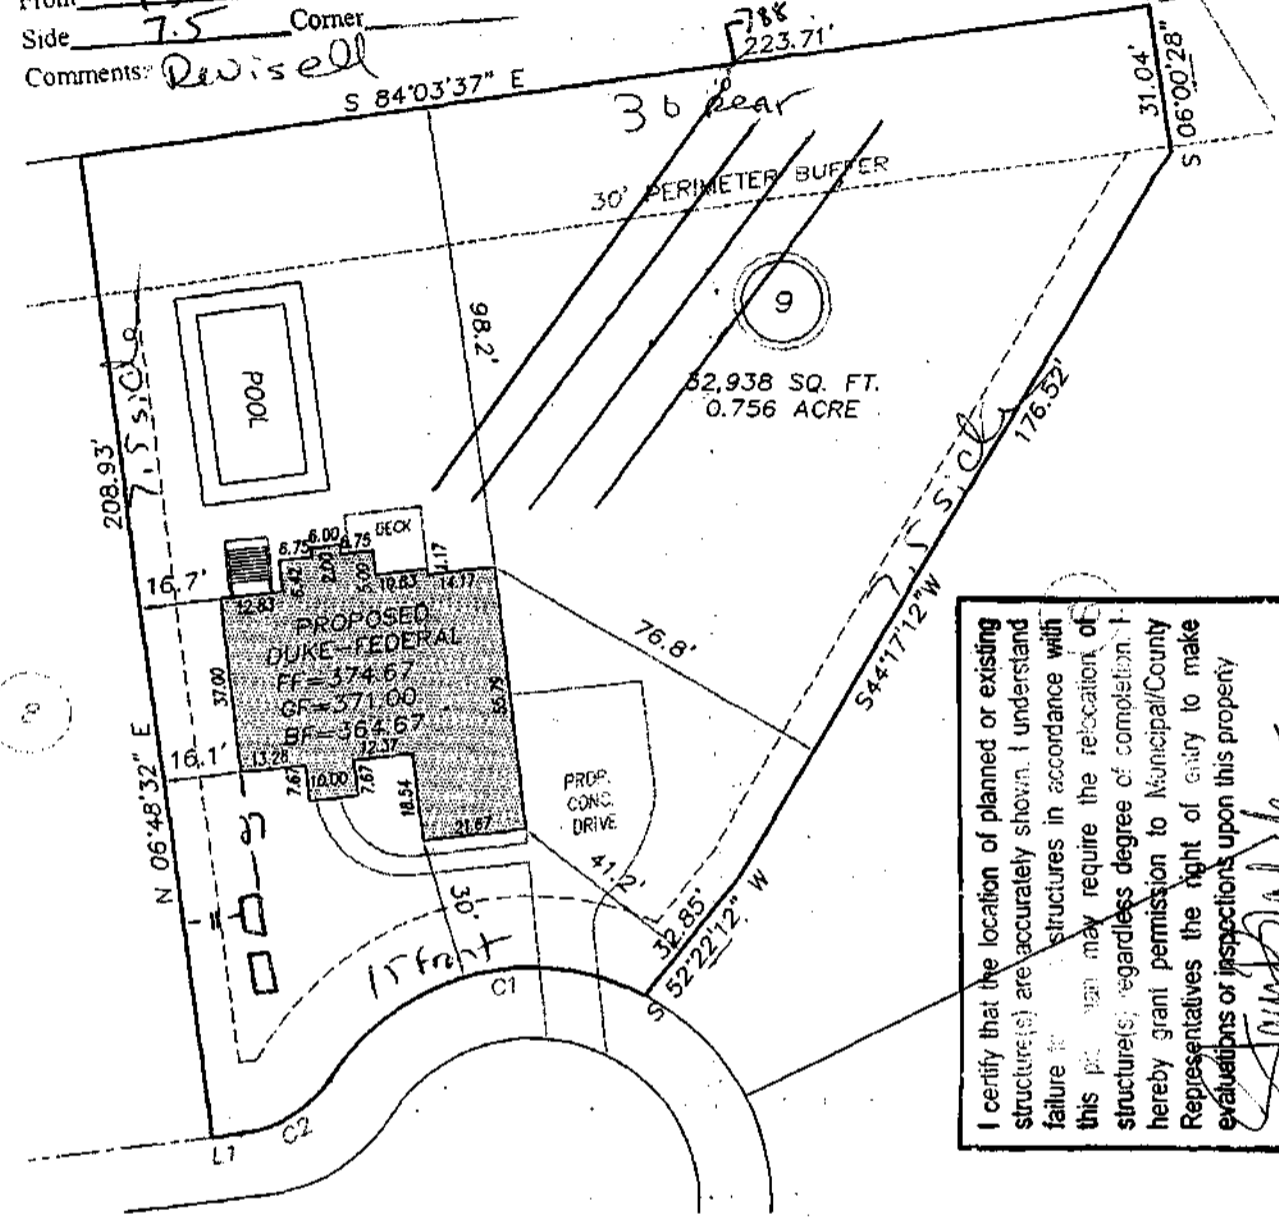

I certify that the location of planned or existing structure(s) are accurately shown. I understand failure of structures in accordance with this plan may require the relocation of structure(s) regardless degree of completion. I hereby grant permission to Municipal/County Representatives the right of entry to make evaluations or inspections upon this property

Signature of Owner or Authorized Agent

HALEYTREE COURT
 45' PUBLIC R/W


C1 R=50.00' L=75.22' S89°12'17"W 68.33'
 C2 R=25.00' L=22.12' S71°27'25"W 21.41'
 L1 N83°11'28"W 6.18'

PROPOSED IMPERVIOUS AREAS	
HOUSE	2858 SQ. FT.
DRIVE	1540 SQ. FT.
POOL	700 SQ. FT.
TOTAL	5098 SQ. FT.
ALLOWABLE	5211 SQ. FT.

SETBACKS	
FRONT	15'
REAR	15'
SIDE	7.5'
CORNER SIDE	15'
FROM BUFFER	20'

PRELIMINARY
 NOT FOR RECORDATION,
 SALES OR CONVEYANCE

LEGEND	
EIP	EXISTING IRON PIPE
IPS	IRON PIPE SET
R/W	RIGHT OF WAY
N/F	NOW OR FORMERLY

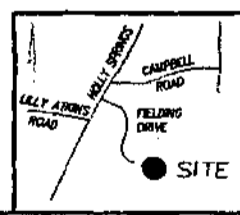

LS GRIFFIN LAND SURVEYING, INC.
 P.O. BOX 148
 FOUQUAY-VARINA, NC 27526
 (919) - 567-1963

DRAWN BY MPG DATE 10/1/05
 CHECKED BY MPG SCALE 1" = 40'

PLOT PLAN FOR
TOLL BROTHERS, INC.
 THE OAKS AT MEADOWRIDGE
 PHASE 1
 LOT 9
 4708 HALEYTREE COURT
 WAKE COUNTY SWIFT CREEK TOWNSHIP