


NASH COUNTY HEALTH DEPARTMENT

REF NO L691 IMPROVEMENTS PERMIT	DATE 02.22.94	TWP BAILEY	MAP TAX NO. 276400026370
REQUESTER ARNES SHELTON E JR P 1 BOX 117 AILEY NC 27807 TELEPHONE 235-4221	OWNER BOYKIN IRA C RT 1 BOX 120 BAILEY NC 27807		
SPECIFICATIONS .03 AC; WP #1166W		6708 Lee St	
LOCATION/DIRECTION LEE ST/OFF 1105 E/S SOUTH OF 264B		SIGNATURE OF OWNER OR AUTHORIZED AGENT	
FEE	LAND SIZE		
RECEIPT# 7067 REV# 9177			

#BEDRMS <u>3</u>	DISPOSAL <u>No</u>	OTHER <u>N/A</u>	TYPE.SYS <u>C</u>
SZ.TANK <u>1000</u>	SZ.CHAMB <u>N/A</u>	NITRIFI <u>300'x3'</u> 4 lines at 75' each	OPER.REQ <u>No</u>
SITE.LOC <u>11:10</u>			

REMARKS: Install system at 24" max. trench depth, along flagged contour, stay 50' from both wells, 10' from prop. lines,

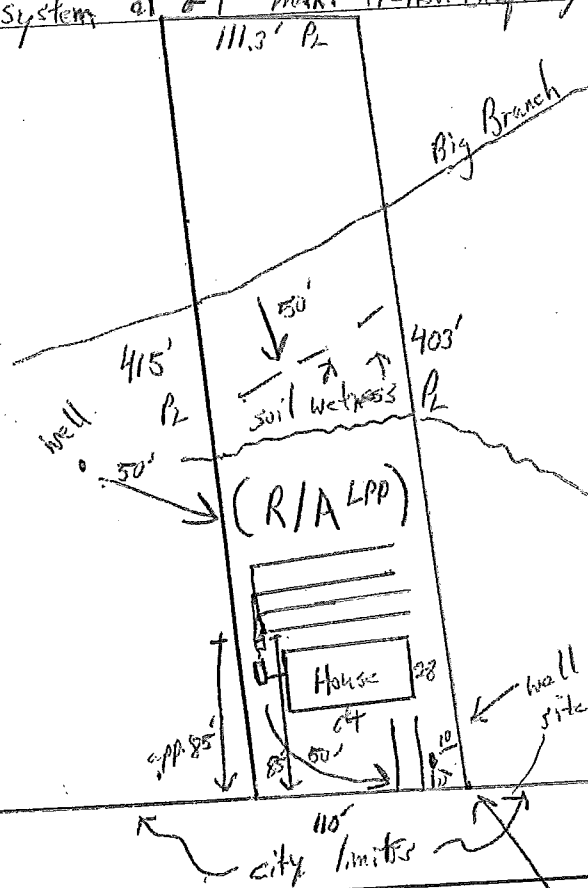

* Stay 100' from public water supply well *

* Repair of system will require a low pressure pipe system due to lack of space *

* Contractor * - call before beginning installation *

DATE ISSUED 3-4-94 ✓
DATE APPROVED 5/26/94 ✓

ENV. HEALTH SPEC. Jay Bright
ENV. HEALTH SPEC. Jay W. Smith for R/S