

JOHNSTON COUNTY ENVIRONMENTAL HEALTH DEPARTMENT

309 E. Market Street
 Smithfield, North Carolina 27577
 Telephone: 919-989-5180 • Fax: 919-989-5190

2:00


Application # 96852 Parcel # _____
 Name: Legacy Custom Homes Address: 105 Bentley Way Clayton
 Location: SR-1003 T/L on SR-1700 down on right
 Facility - Type: Residential S/D & Lot # The Creeks at Millstone Lot-10
 Soil Site Classification: P.S. LTAR: .35
 Bedrooms: 4 Design Daily Sewage Flow: 480 gpd Lot Area: ± 1.75 AC
 New Construction: Repair: _____ Upgrade: _____ Water Supply: Public
 Septic Tank Size: 1000g Grease Trap Size: N/A
 Pump Tank Size: 1000g Pump(s) Size: 12 gpm w/ 11' TDH w/ 8" drawdown
 Drainfield Type: Pump to Accepted drainlines Square Feet: 1080 sq' Accepted
 # of Lines: 4 Width: 3' Length: 90' Depth: 32"
 Design/Layout by: _____ Improvement Permit Issued by: R. Mills Date: 6-21-12 Exp. Date: 6-21-17
 Inspection: Lines: 4-90 62-flow 1203 H Septic Tank: 2m D-Box: 2m
 Pump Tank: 2m 9-25-12 Pump(s)/Pressure: _____
 Drainage: _____ Contractor: Glenn Todd

AUTHORIZATION FOR WASTEWATER SYSTEM CONSTRUCTION

ISSUED BY: Robert Mills DATE ISSUED: 6-21-12

By rule, this septic system requires the use of an effluent filter and a waterproof seal. A riser and septic marker may also be required. Systems shall be installed as shown in sketch or according to attached plans and specifications. Any unauthorized site disturbance, filling, soil removal, or layout changes may result in the permit being revoked. Improvement permit is valid for 5 years from date of issuance unless otherwise indicated. The owner/agent accepts & verifies the conditions of the permit as indicated below.

OWNER/AGENT: _____ DATE: _____

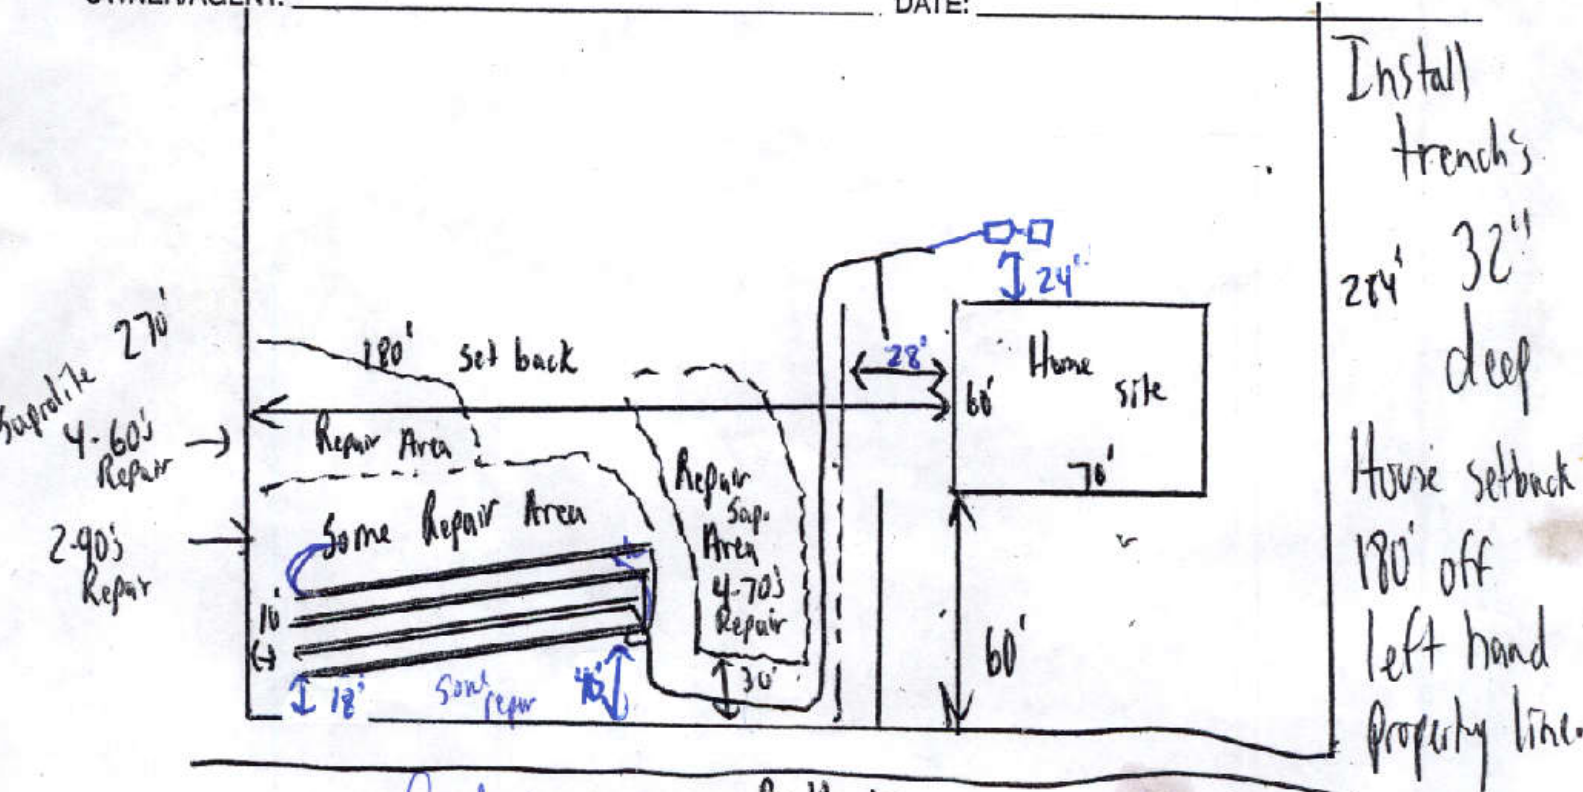

OPERATION PERMIT BY: Robert Mills Bentley Way DATE: 10-19-12

208