

Environmental Services - Water Quality
Onsite Wastewater Scan Data Entry Form

PERMIT #:

PIN #:

OP DATE:

SYSTEM USE:

- House
- Mobile Home
- Business
- Other

SEWAGE TYPE:

- Domestic
- Industrial

PUMP/SIPHON?:

- Yes
- No

PRESSURE MANIFOLD:

- Yes
- No

SYSTEM TYPE:

- I
- II
- III
- IV
- V
- VI
- Other

SUB TYPE:

- A
- B
- C
- D
- E
- F
- G

NBR BEDROOMS:

- 1
- 2
- 3
- 4
- 5
- 6
- Other

MAINT. SCHEDULE:

- Yes
- No

CERT. OPERATOR

- Yes
- No

GT ST PT

-
-
SIZE

- 750
- 900
- 1,000
- 1,200
- 1,500
- 1,800
- 2,100
- 2,500
- 3,000
- 4,000
- 5,000
- 8,000
- 10,000
- Other
- None/NA GT or PT

DRAINFIELD SIZE(SQ. FT.)

DRAIN TYPE:

- Stone
- EZ Flow
- Infiltrator
- Biodiffuser
- Cultec
- Drip
- Hancor
- Large Dia. Pipe
- Multi-Pipe
- Other

MAX DEPTH (IN.):

- 12 in. or less
- 18 in. or less
- 24 in. or less
- 26 in. or less
- 28 in. or less
- 30 in. or less
- 32 in. or less
- 36 in. or less
- Other

STONE DEPTH (IN.):

- 8 in. or less
- 12 in. or less
- 18 in. or less
- 24 in. or less
- Other

TRENCHES:

- Individual
- Bed

TRENCH WIDTH (IN.):

- 12 in. or less
- 18 in.
- 24 in.
- 36 in.
- 6 ft. or less
- 9 ft. or less
- Other

BSM

WAKE COUNTY HEALTH DEPARTMENT SEPTIC TANK LAYOUT AND PERMIT

READY
30267

TAX MAP NO. 686 PARCEL NO. 30(5)

PERMIT NO. B. 30267

CONTRACTOR _____

OWNER _____

DATE _____

LOCATION _____

SUBDIVISION NAME Farmdale Acres LOT NO. 11 B SECTION OR BLOCK NO. _____

S. R. NO. 204

REPAIR ORIGINAL PERMIT NO. _____

GARBAGE DISPOSAL UNIT YES NO

HOUSE MOBILE HOME BUSINESS

NO. BEDROOMS 3 LOT AREA 2.5 AC

SIZE OF TANK (3 FEET x 2.5 FEET) 1000 gal.


NITRIFICATION LINE 3 (3 x 12') 1000 sq. ft.

DEPTH OF STONE IN LINES: 12"

RISER AND BAFFLE REQUIRED PUMP REQUIRED

WATER SUPPLY: INDIVIDUAL PUBLIC OTHER

- PERMIT VOID 36 MONTHS FROM DATE OF ISSUANCE.
- PERMIT VOID IF NOT IN COMPLIANCE WITH ZONING REGULATIONS
- PERMIT MAY BE VOIDED IF SITE ALTERATIONS MADE

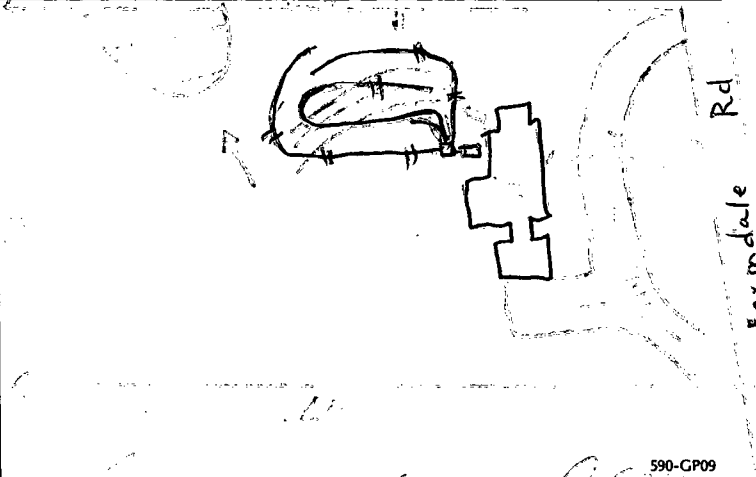

LAYOUT BY [Signature]

DATE 10-6-86

INSTALLED BY [Signature]

APPROVED BY [Signature]